


1

2

3

4

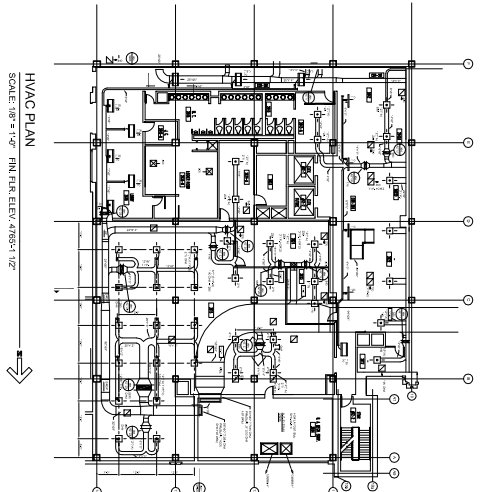

SYSTEMS ENGINEERING LTD.
P.O. BOX 3891
SEA COWS BAY
TORTOLA, VG 1110, B.V.I.
TEL: 284.494.2987
FAX: 284.494.0775
EMAIL: symeng@systemsengineer.com

NOTES


01 DO NOT USE THIS DRAWING FOR CONSTRUCTION UNLESS THE WORDS "CONSTRUCTION SET" APPEARS IN THE REVISIONS COLUMN

02

**A. O. SHIRLEY RECREATIONAL
GORUND: GRANDSTAND**

ROAD TOWN
TORTOLA
BVI

FOR CONSTRUCTION

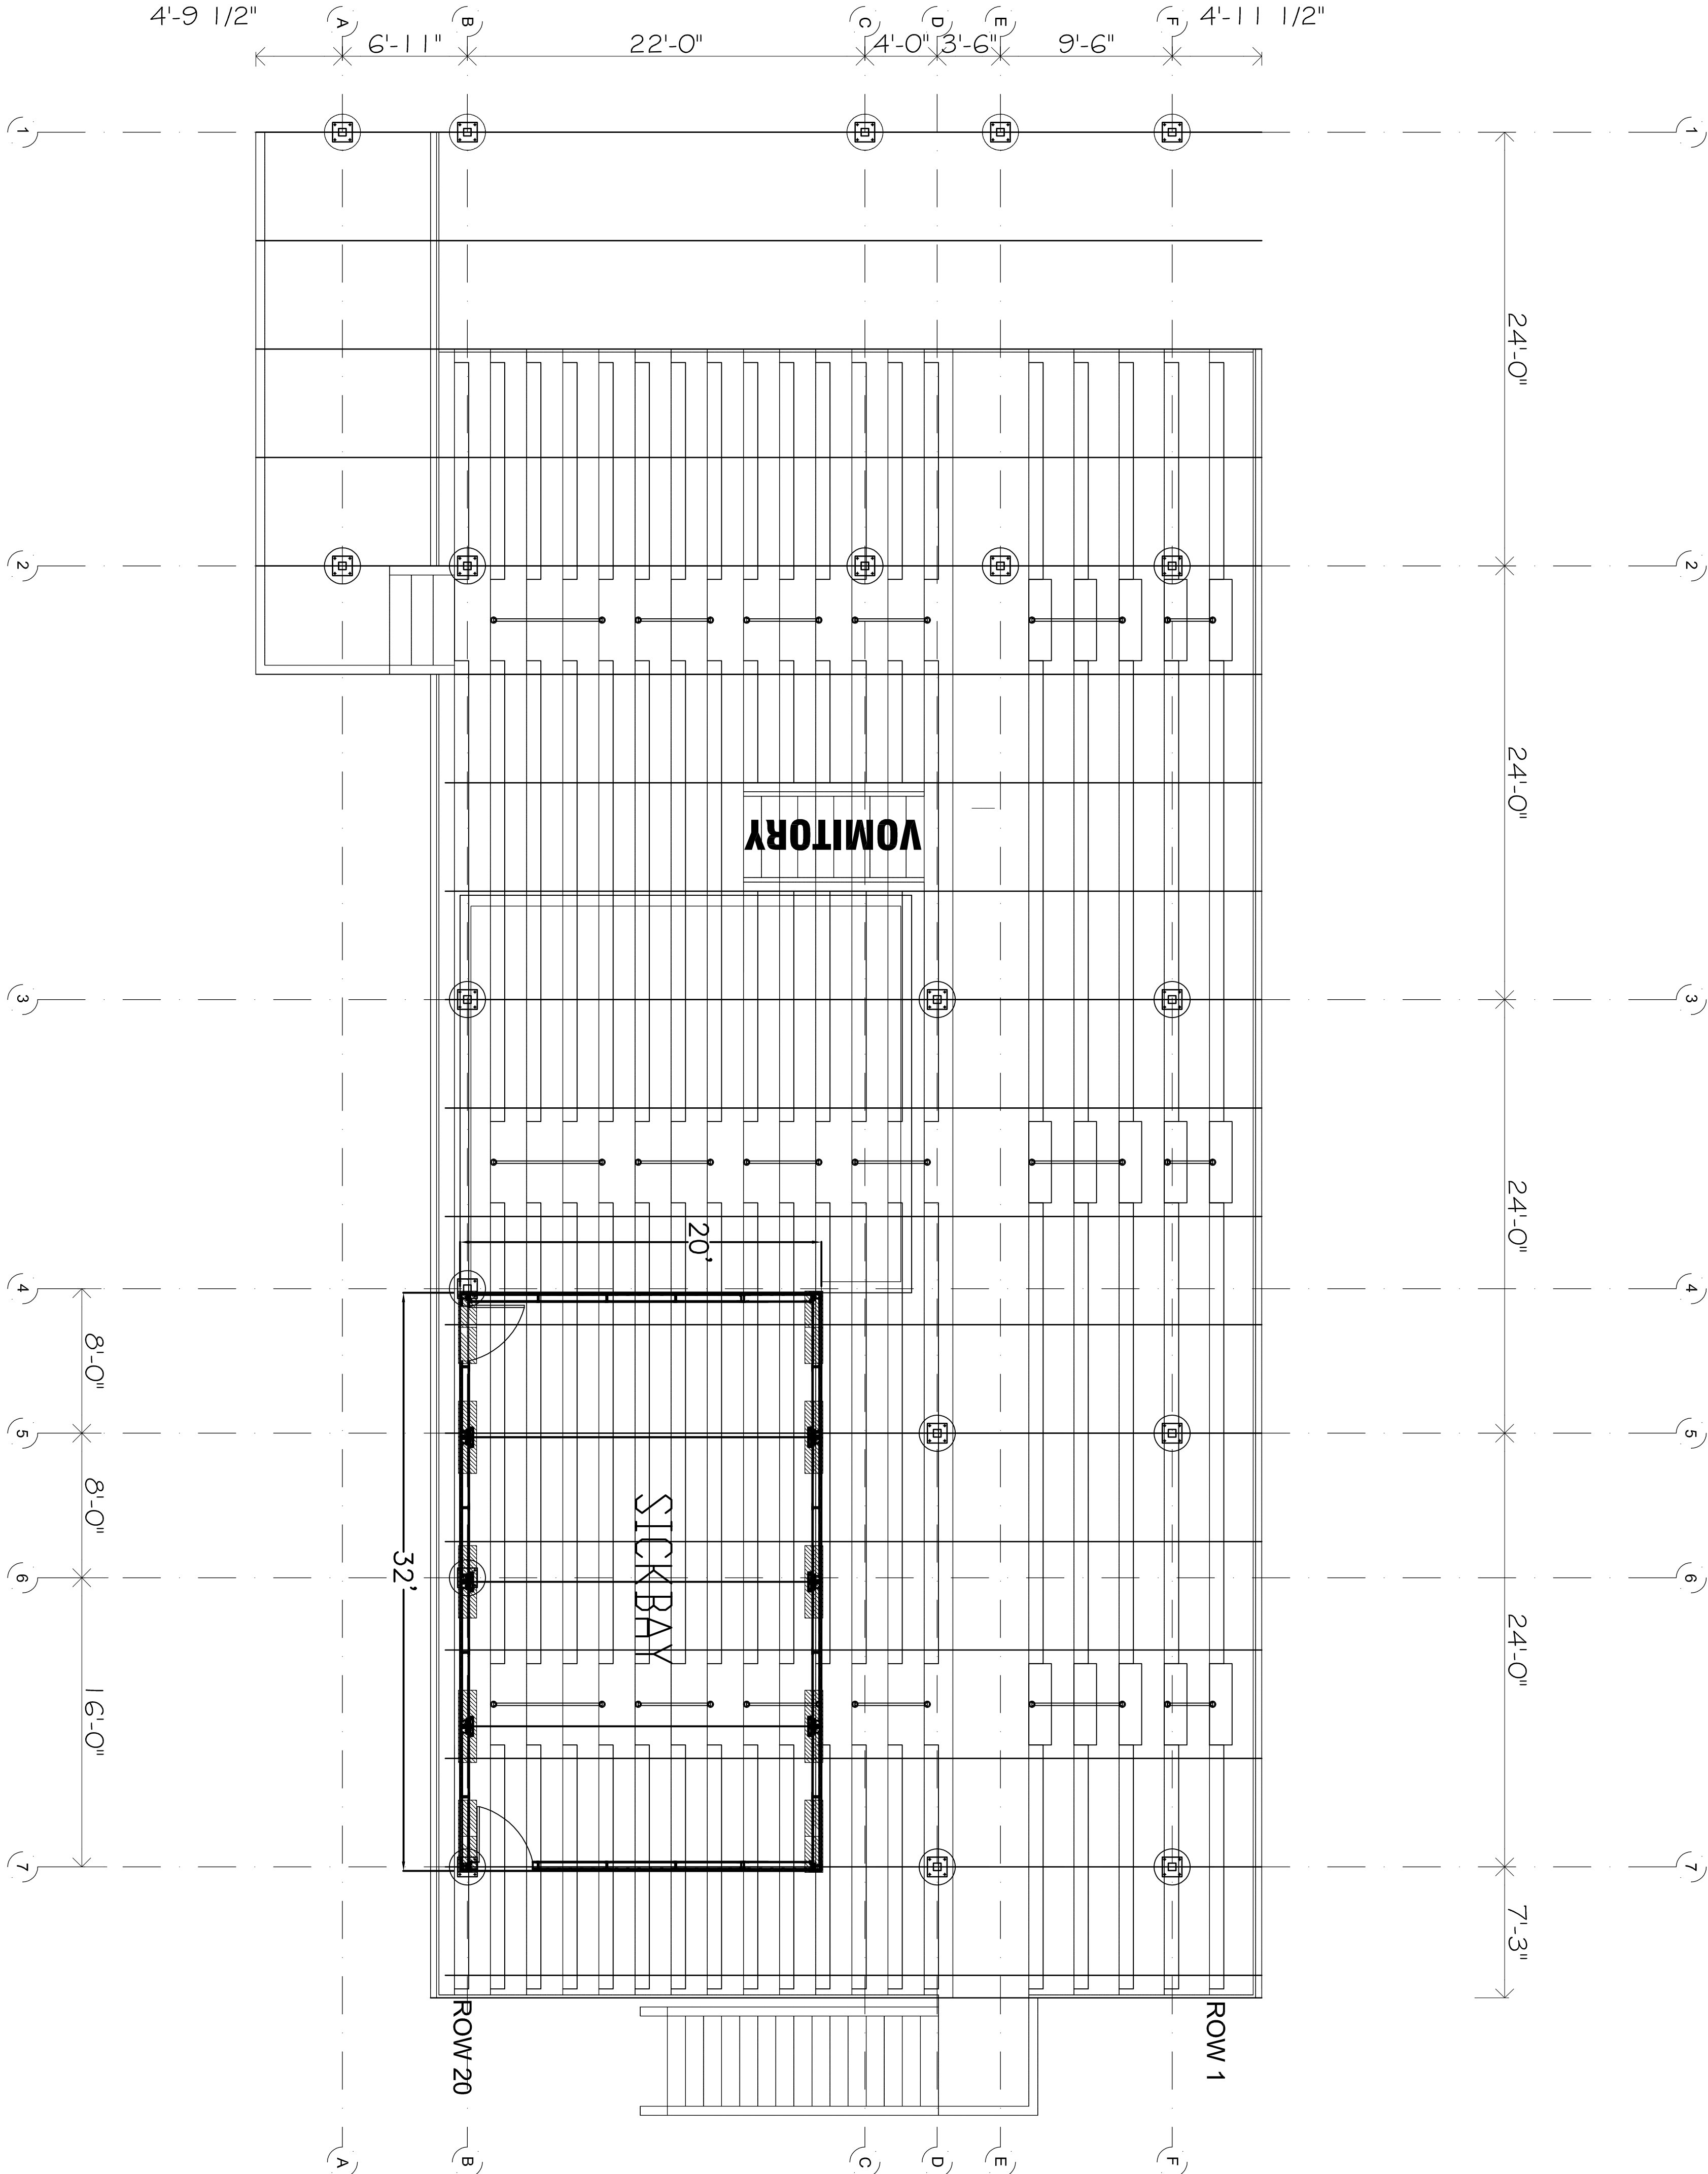

A

B

C

D

GA: GRANDSTAND AS-BUILT PLAN

SCALE : 3/16" = 1'-0"

DWG NO:

**GRANDSTAND
AS-BUILT PLAN**

GS-100

VERS. 3.0 – 071219

| | | | |
|-------|------------------------|-------|--------|
| 01 | CONSTRUCTION ISSUE | RT | 190729 |
| A | PRELIM. ISSUE TO ARCH. | RT | 130324 |
| REV # | DESCRIPTION | DRAWN | YMM/DD |

| | |
|--------------------|----|
| ISSUE INFORMATION. | 01 |
|--------------------|----|

| | |
|-----------|----|
| DESIGNER: | RT |
|-----------|----|

| | |
|--------|----|
| DRAWN: | SW |
|--------|----|

| | |
|----------|--|
| JOB REF: | |
|----------|--|

| | |
|-------|----------|
| DATE: | 19 05 24 |
|-------|----------|

| | |
|--------|----------|
| SCALE: | AS NOTED |
|--------|----------|

| | |
|-----------|--|
| DWG NAME: | |
|-----------|--|